

ITEM	
MANAGER'S REPORT #	06
COUNCIL MEETING	06
	96/02/19

TO: CITY MANAGER

1996 FEBRUARY 14

FROM: DIRECTOR PLANNING & BUILDING

SUBJECT: 23 S. HOWARD AVENUE, BURNABY, B.C.

PURPOSE: To provide Council with additional information regarding the unauthorized conversion of a crawl space at 23 S. Howard Avenue, Burnaby, B.C., to habitable living area.

RECOMMENDATION:

- 1) **THAT** a copy of this report be sent to Ante and Sonja Pocrnic at 23 S. Howard Avenue, Burnaby, B.C. - V5B 3P4.

REPORT

At the regular Council meeting of 1996 January 22, Council received a delegation and an accompanying staff report regarding the unauthorized conversion of a crawl space at 23 S. Howard Avenue, Burnaby, B.C., to habitable living area. Council subsequently requested that staff provide additional information. This report addresses that request.

In determining the development density of buildings on single-family lots, Burnaby's Zoning Bylaw considers two factors. Gross Floor Area, which is the total area of all the floors measured to the extreme outer limits of the building, and the more restrictive above grade floor area that regulates all of the floors above the cellar, are both examined when determining the permitted density.

In the case of smaller lots, the maximum above grade floor area regulation and the maximum total floor area restriction tend to work out to be very close. For example, of a 33 ft. by 120 ft. lot, a maximum total floor area that can be developed is 2,376 sq. ft. and a maximum floor area above a cellar is 2,192 sq. ft. This leaves a maximum floor area that can be developed in the cellar of 184 sq. ft.

In calculating the development densities for larger lots, a much greater percentage of the floor area is required to be in the cellar in order to achieve the maximum floor area that can be developed. Therefore, under current regulations, small lots can achieve a higher percentage of floor area above grade than larger lots.

On a flat site, the visible bulk of a building with a cellar is similar to one with a crawl space. However, the density of the land use is very different. Developed cellar space is usable floor area to the inhabitants of the house with bedrooms, recreation rooms, dens, workshops, utility rooms and often unauthorized secondary suites. In the case of a lot with even a very small slope, the cellar adds visible bulk to the building, creating the look of a three-storey building from the downhill side.

If cellars were to be excluded from the calculation of development density, a typical small lot (33 ft. x 120 ft.) could achieve an equivalent floor area ratio of up to 0.90. This corresponds to development densities in the RM2/RM3 Districts which permit medium density multi-family development. Excluding the floor area of the cellar would probably also result in a general increase in property values for small lots due to an increase in buildable floor space. If cellars were to be excluded from the maximum total buildable floor area, then consideration would have to be given to a corresponding reduction in the overall development density for that zone or zones.

Staff of the Plan Checking section of the Building Department have reviewed the approved plans on file for 23 S. Howard Avenue and have confirmed that when the house was built, it was 69 sq.ft. less than the maximum gross floor area permitted. Excavating the crawl space and converting it to habitable space has increased the floor area by 694 sq.ft. The result in gross floor area of the single-family dwelling is now 625 sq.ft. larger than allowed by the Zoning Bylaw.

CONCLUSION:

The regulations contained in Burnaby's Zoning Bylaw which regulate development of a single-family lot is designed to restrict both the bulk and the development density of the property. Re-excavating of the crawl space at 23 S. Howard Avenue has resulted in the gross floor area of the single-family dwelling being 625 sq.ft. larger than that allowed by the Zoning Bylaw.

In order for the City to be consistent in its application of its Zoning Bylaw, the property owners will have to restore the crawl space to its previously approved condition.

Reduced copies of the cellar plan, site plan, first floor plan, second floor plan, roof deck plan, front east elevation, rear west elevation, north and south elevations of the property at 23 S. Howard Avenue are available with the City Clerk.

This is for the information of Council.


DWM/BG:ap

cc:  Chief Building Inspector



D. G. Stenson, DIRECTOR
PLANNING & BUILDING

LANE

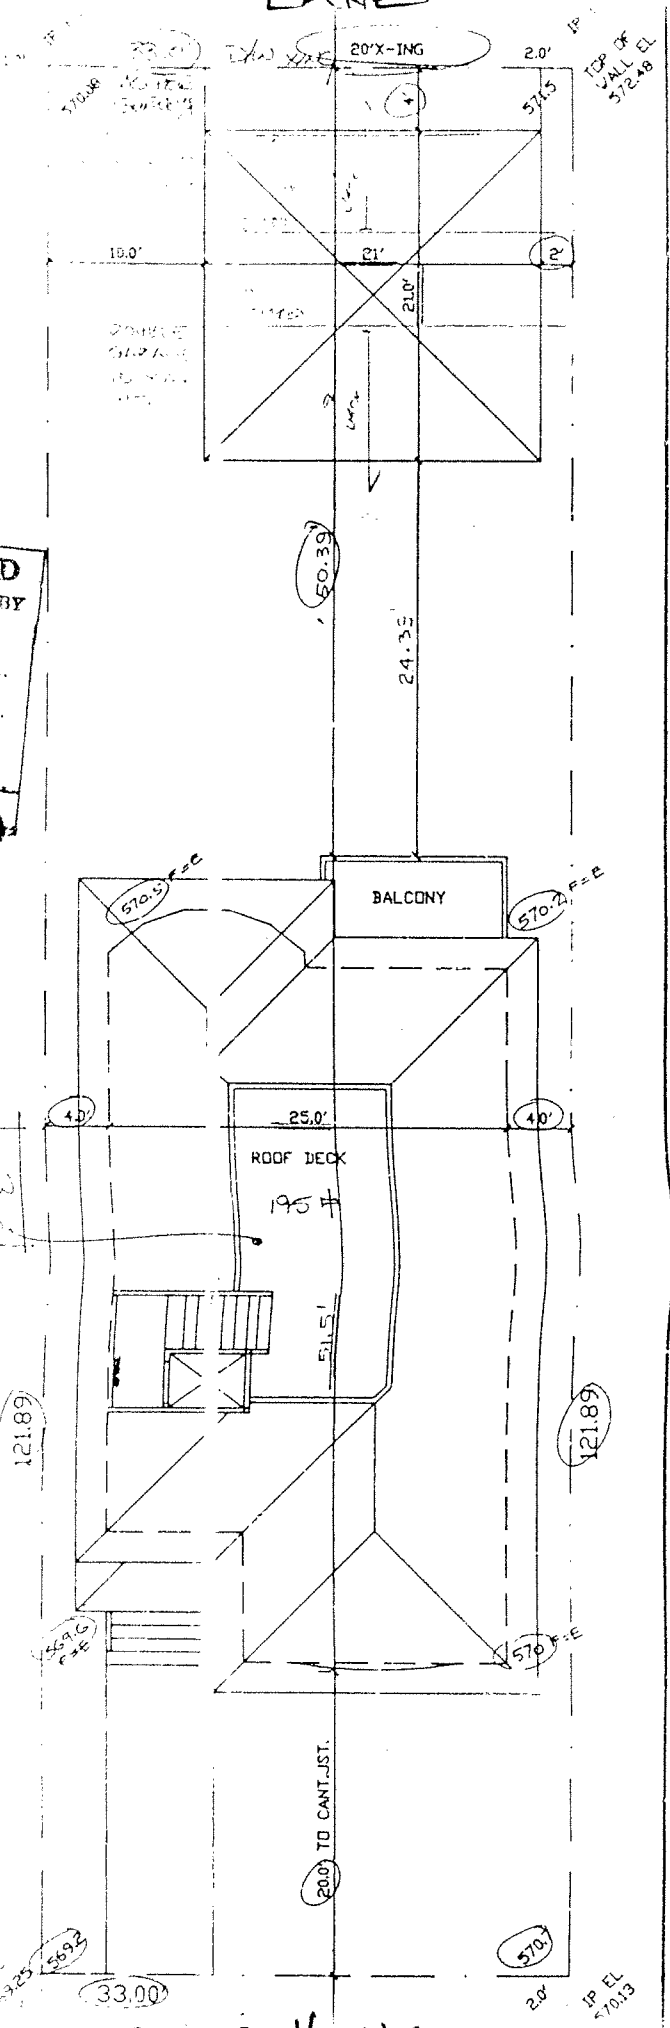


ACCEPTED
 OF PRIMARY
 APR 30 1993
 CITY INSPECTOR
 178399

PRICE COPY

SITE PLAN


22 C HILLARD

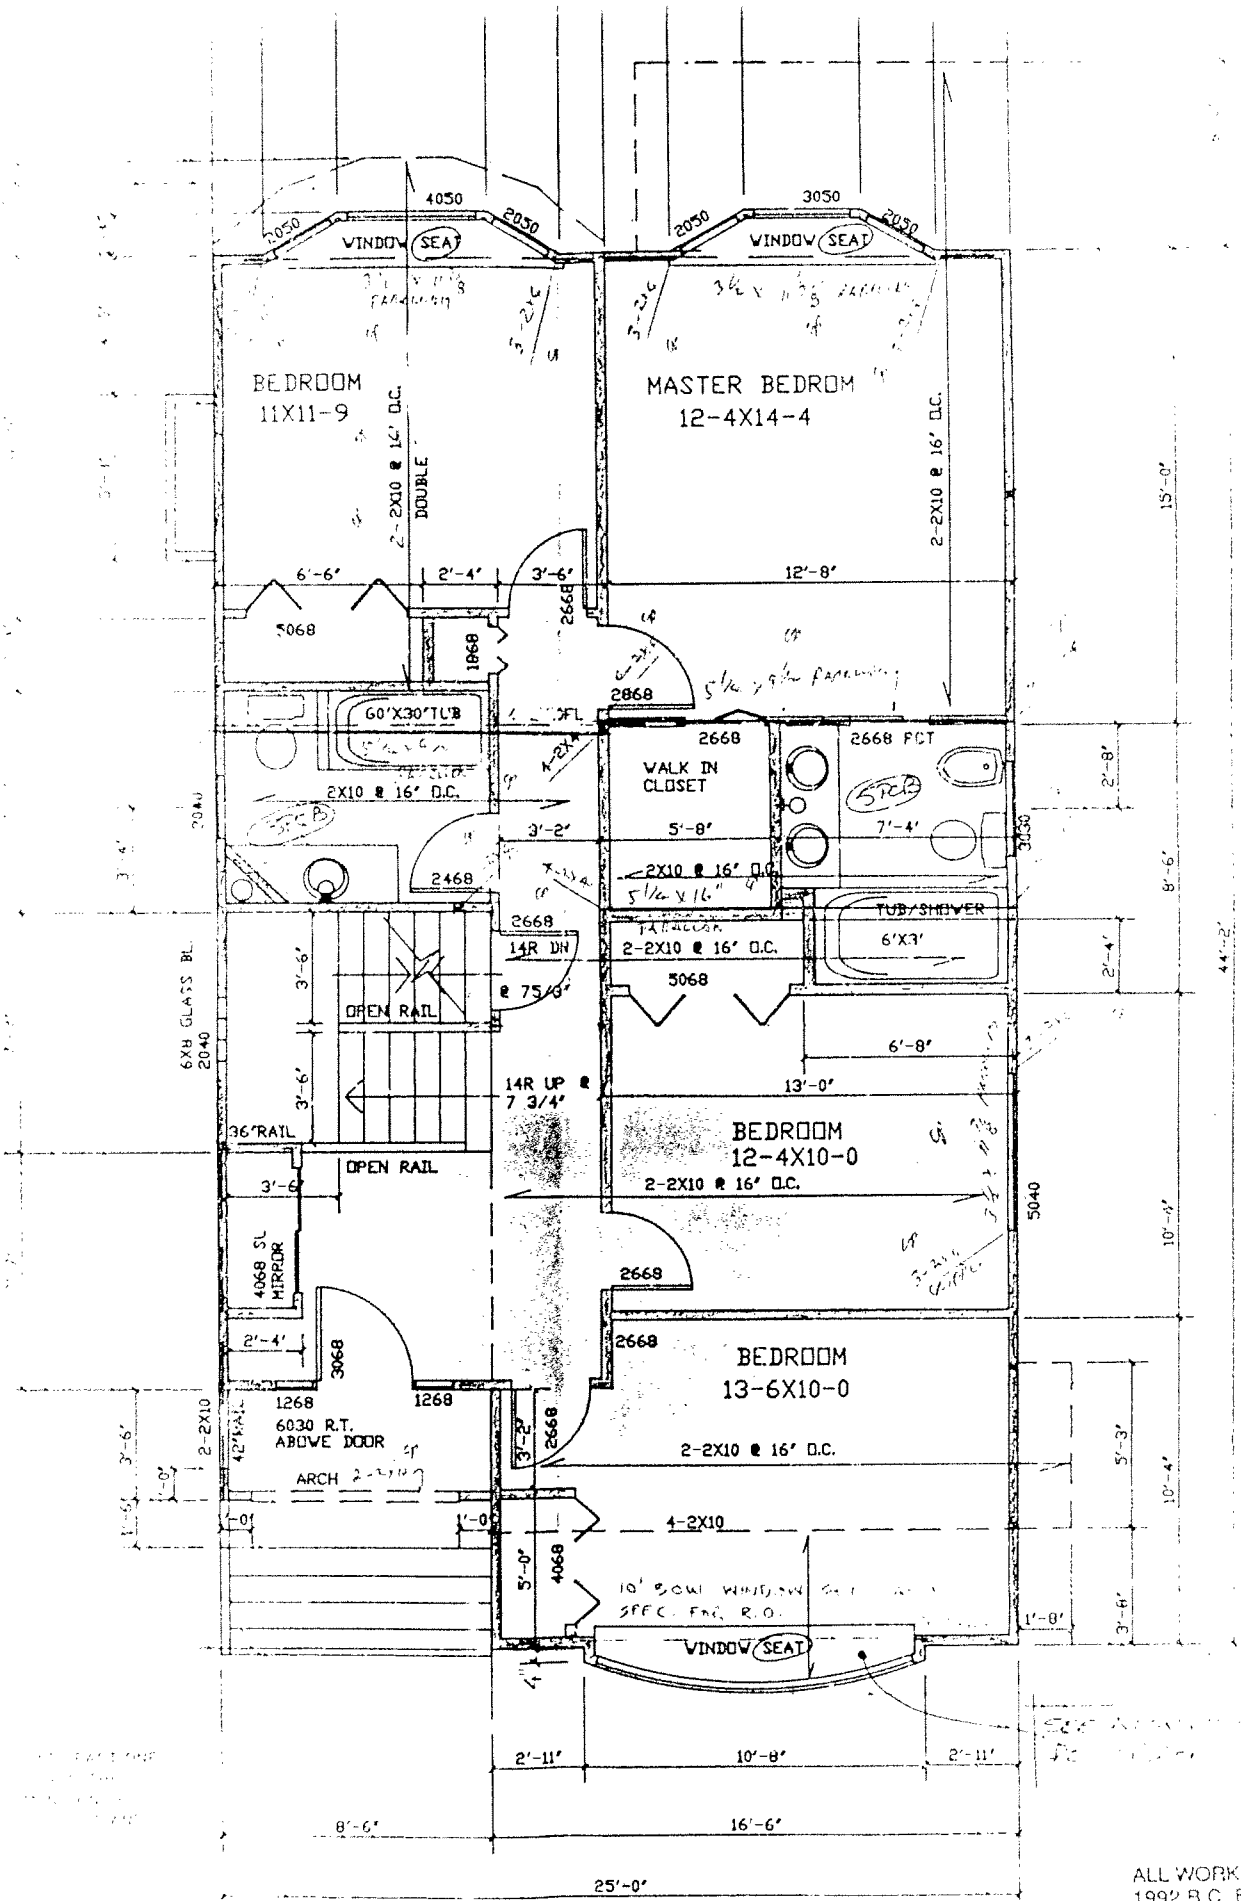

ALL WORK TO CALIFORNIA
1992 B.C. BUILDING CODE

1ST FLOOR PLAN

20099

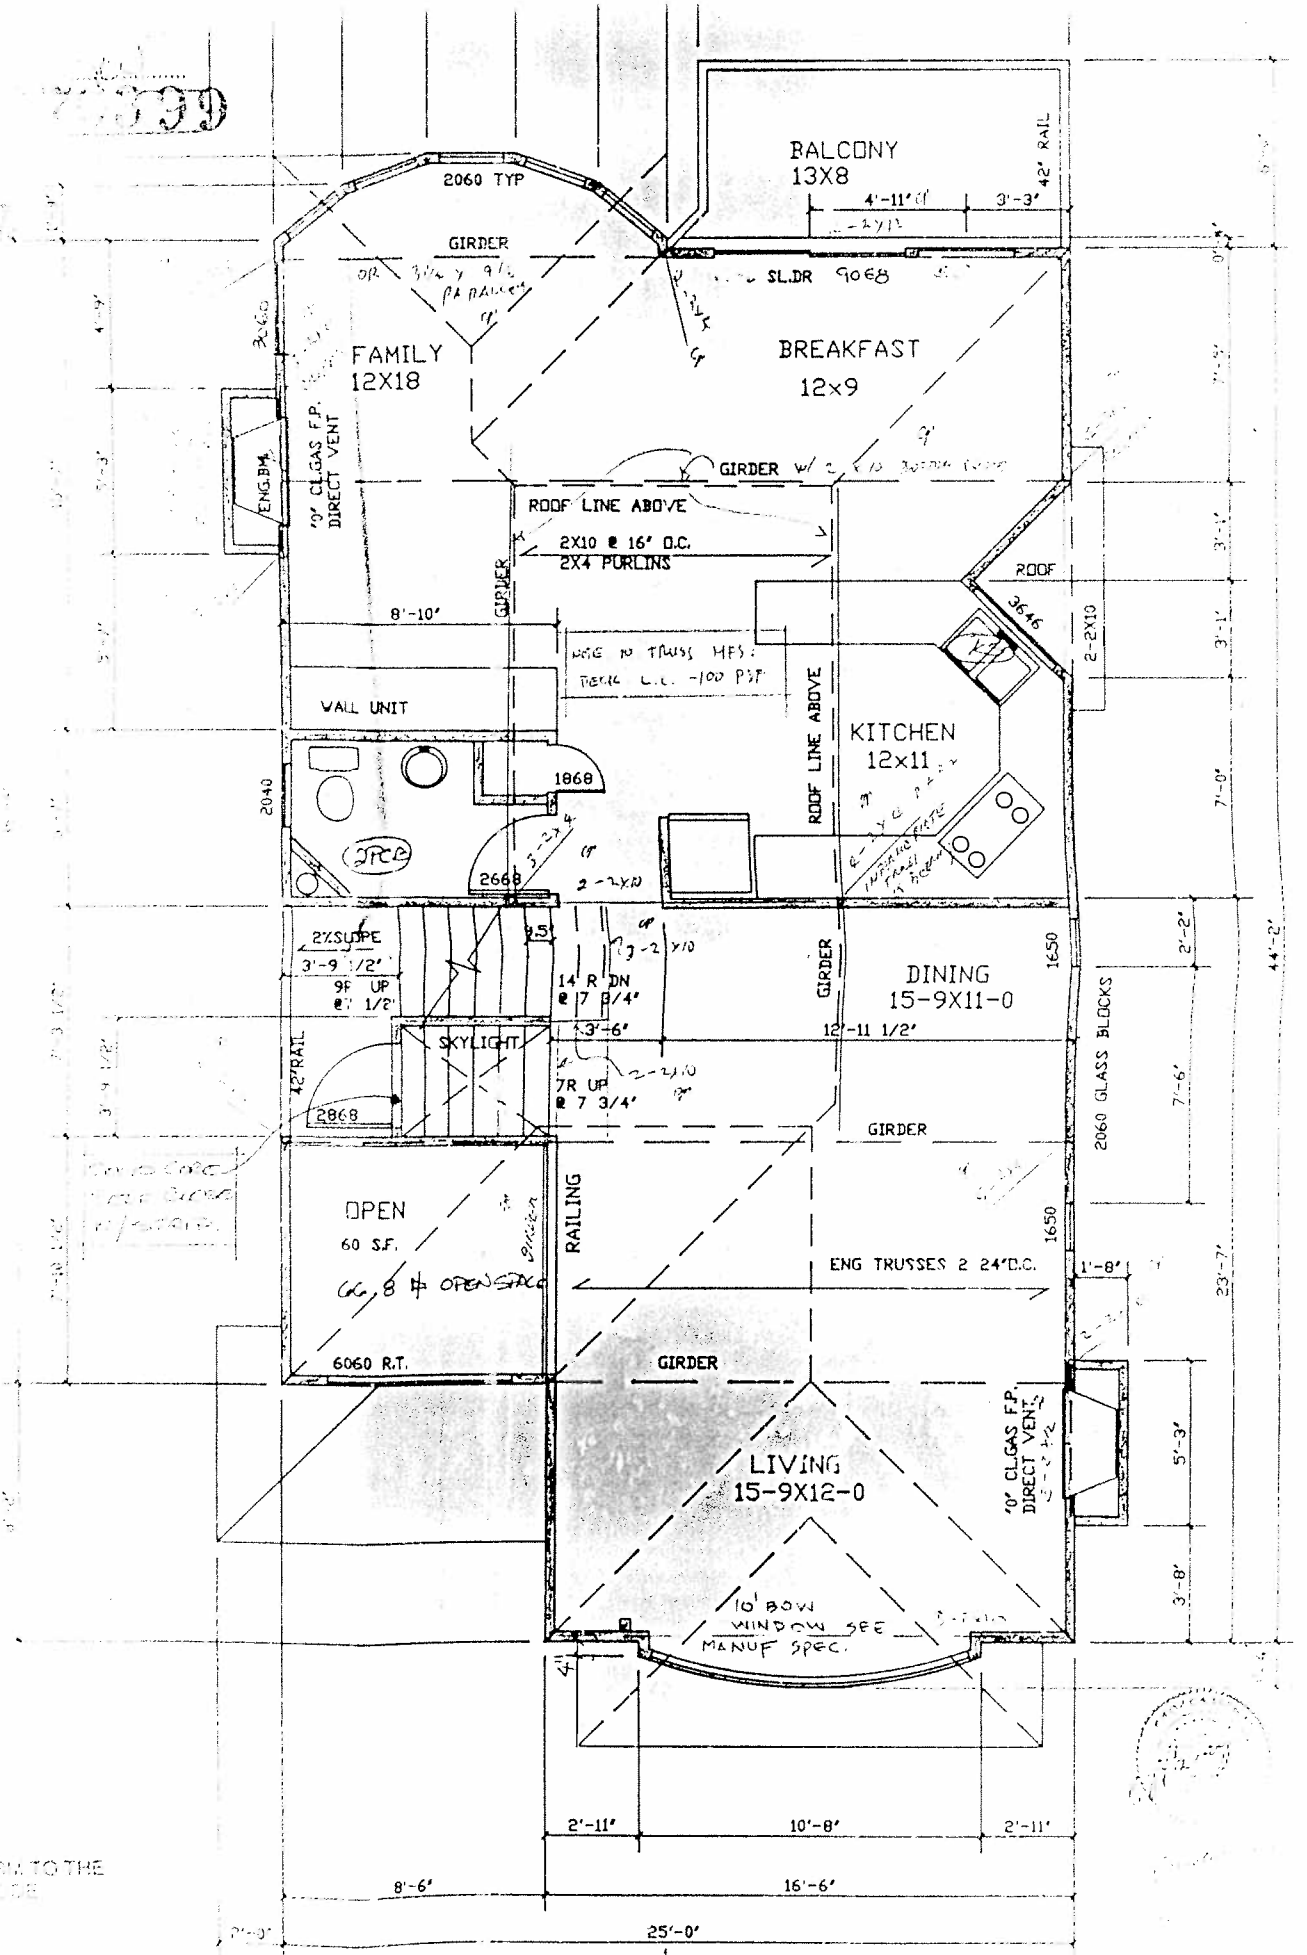


2ND FLOOR PLAN

OFFICE COPY



SEE PLAN TO THE LEFT

Handwritten notes at the bottom of the plan, including dates and initials.

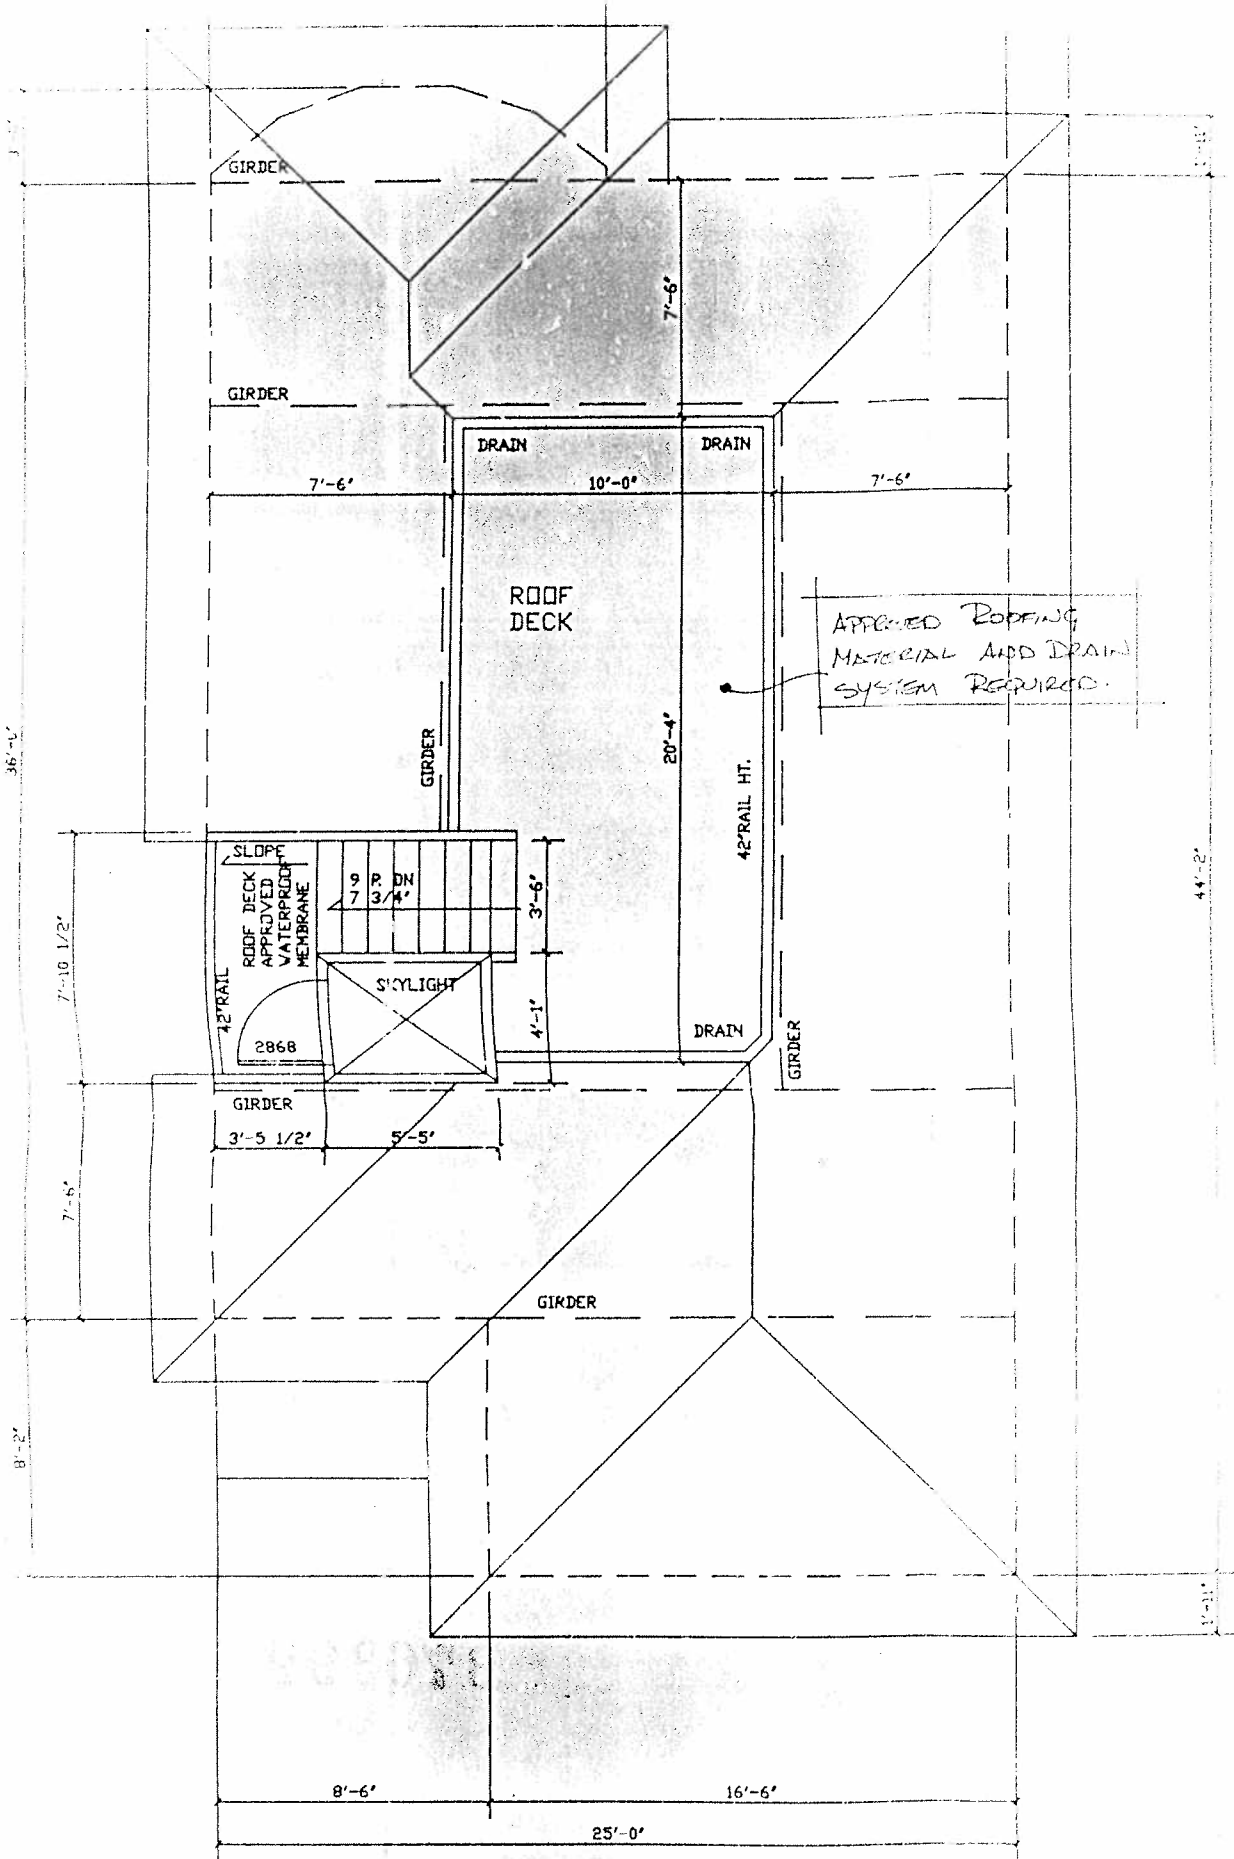

ROOF DECK

CONCRETE TILES
 BUILDING PAPER
 (BY SHEETING CONTRACTOR)

568.5
ROOF TOP

CONC. TILES



GARAGE NOT
 -Roof to slope 1
 System
 -Max. Height: 15
 -App'd fdn. min

575
MAIN FLOOR

570 FIN

569.6
EX. GR. DE

570 FIN GR

2X12 IN STUCCO

570
FIN. GRADE

FRONT EAST

When is aware that gravity
 e may not be possible for the
 connections in the cellar of the
), and pumping may be required.

cc: Jay & Penny
Apr 30/93

DRAWINGS HAVE NOT BEEN CHECKED FOR COMPLIANCE WITH STRUCTURAL REQUIREMENTS AS OUTLINED IN THE 1992 BRITISH COLUMBIA BUILDING CODE. IT IS THE RESPONSIBILITY OF THE DESIGNER, CONTRACTOR AND OWNER TO ENSURE COMPLIANCE. THE BUILDING INSPECTOR AT HIS DISCRETION, MAY AT THE FRAMING STAGE, REQUEST APPROVAL OF THE FRAMING OR PORTION THEREOF, BY AN ARCHITECT OR ENGINEER REGISTERED IN THE PROVINCE OF BRITISH COLUMBIA.

DATE: Apr 30/93

NAME: S. M. BERNIC

(print)


NAME: Jay & Penny

(sign)

598.5

Bldg. AT. OR ROOF TOP

594

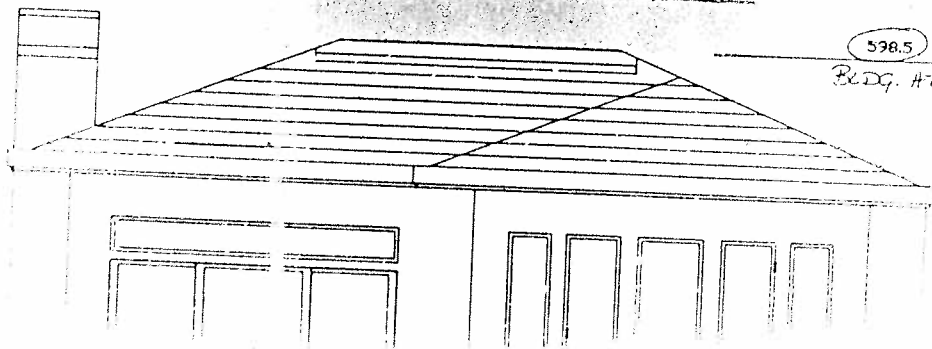


DRAWINGS HAVE NOT BEEN CHECKED FOR COMPLIANCE WITH STRUCTURAL REQUIREMENTS AS OUTLINED IN THE 1992 BRITISH COLUMBIA BUILDING CODE. IT IS THE RESPONSIBILITY OF THE DESIGNER, CONTRACTOR AND OWNER TO ENSURE COMPLIANCE. THE BUILDING INSPECTOR AT HIS DISCRETION, MAY AT THE FRAMING STAGE, REQUEST APPROVAL OF THE FRAMING OR PORTION THEREOF, BY AN ARCHITECT OR ENGINEER REGISTERED IN THE PROVINCE OF BRITISH COLUMBIA.

DATE: Apr 30/95

NAME: D. Borovic

NAME: [Signature]
(sign)

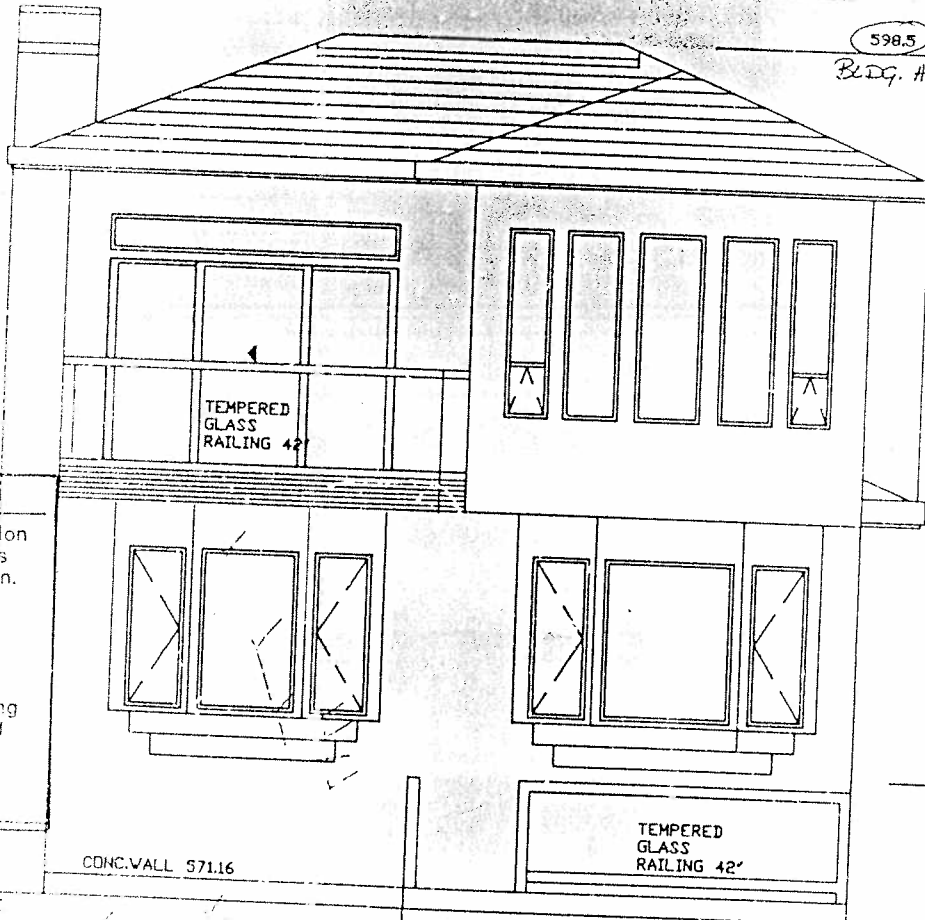

598.5
Bldg. HT. OK ROOF TOP

594
ROOF DECK

575
MAIN FLOOR

570.2
F-E GRADE

CONC. WALL 571.16

TEMPERED GLASS RAILING 42'

REAR WEST
566 CELLAR SLAB
CELLAR OK
@ MAX.

PERMIT
... for excavation
... forms
... elevation.
... excavation
... in the
... to zoning
... inspector.
130-135

NOISE ABATEMENT
... HOURS
7 am to 10 pm
9 am to 10 pm


NO.	DESCRIPTION	DATE	REVISION
1
2
3
4
5
6
7
8

ORIGINAL
HOME DESIGN STUDIO
1471 Cliff Ave.
Burnaby, B.C.
V5A 3K3
(604) 420-0942

project name: **PBORNIC RESIDENTIAL**
design: **DAMIR BOROVIC**
drawn: **DAMIR BOROVIC**
checked: **DAMIR BOROVIC**



GIVEN PERM (78) = 4100
 OPEN ACTUAL = 4100

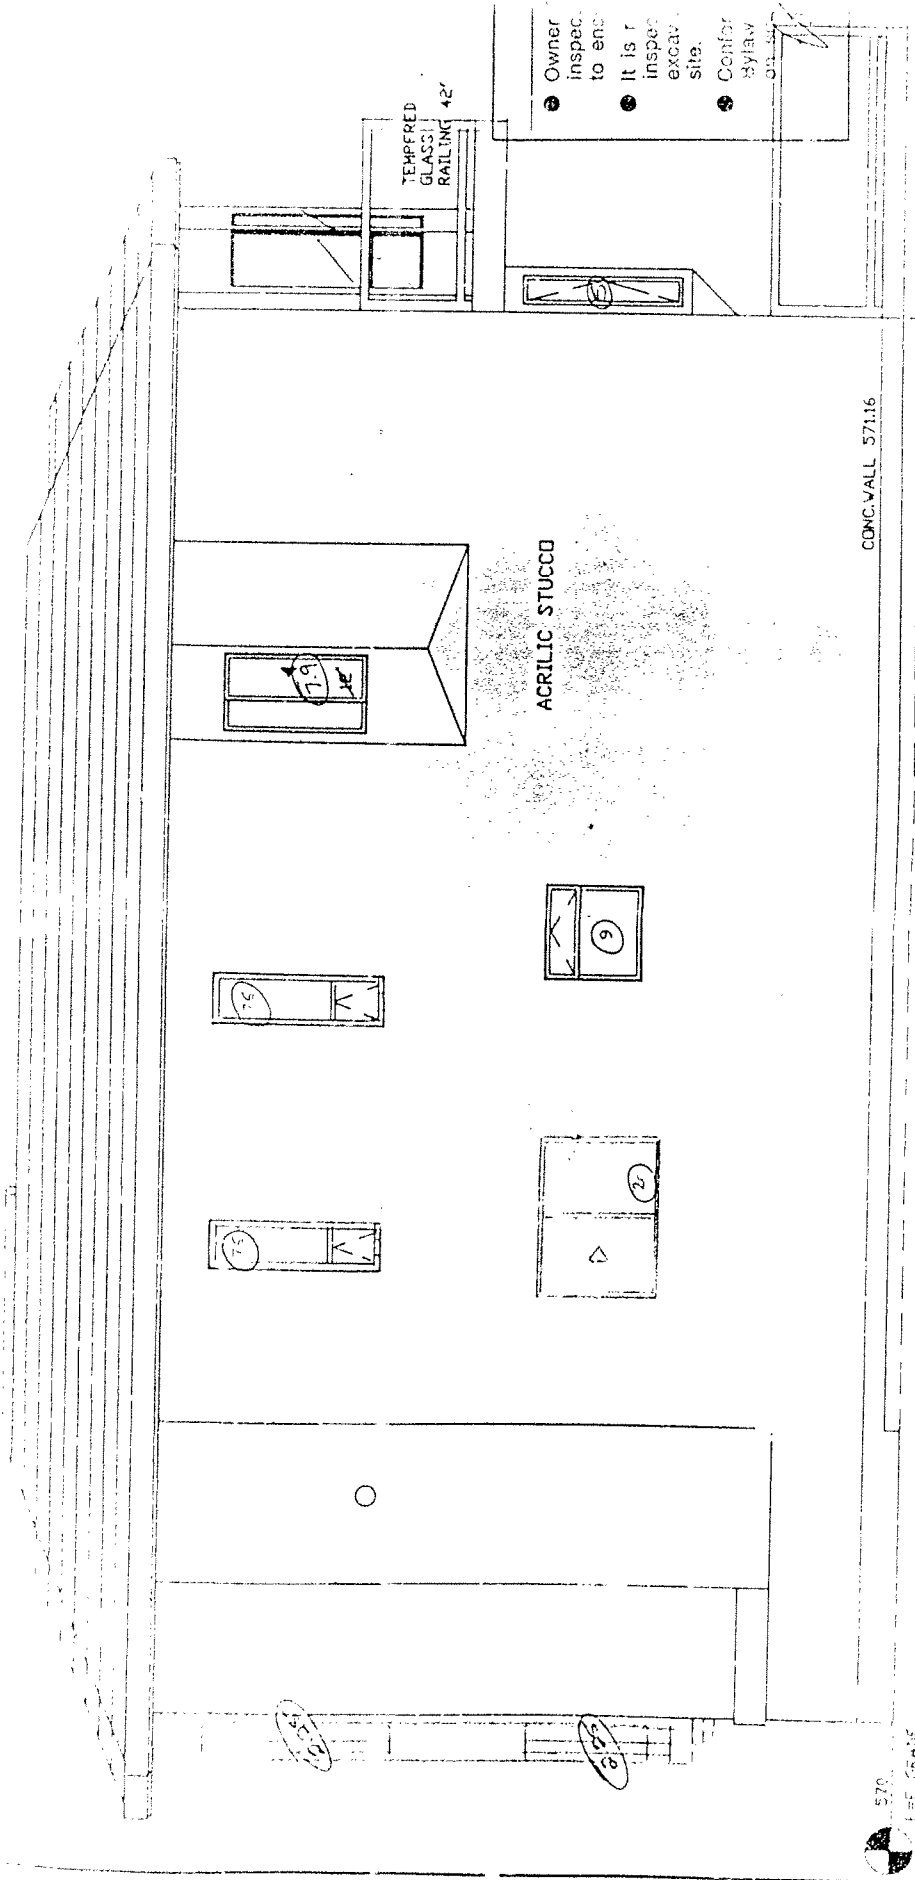

CONC.VALL 571:16

L.D. @ 4.0 = 1039.9
 WALL AREA = 1039.9
 OPEN PERM (78) = 4100
 OPEN ACTUAL = 4100


ERTH

4100

PROPOSED

570

570

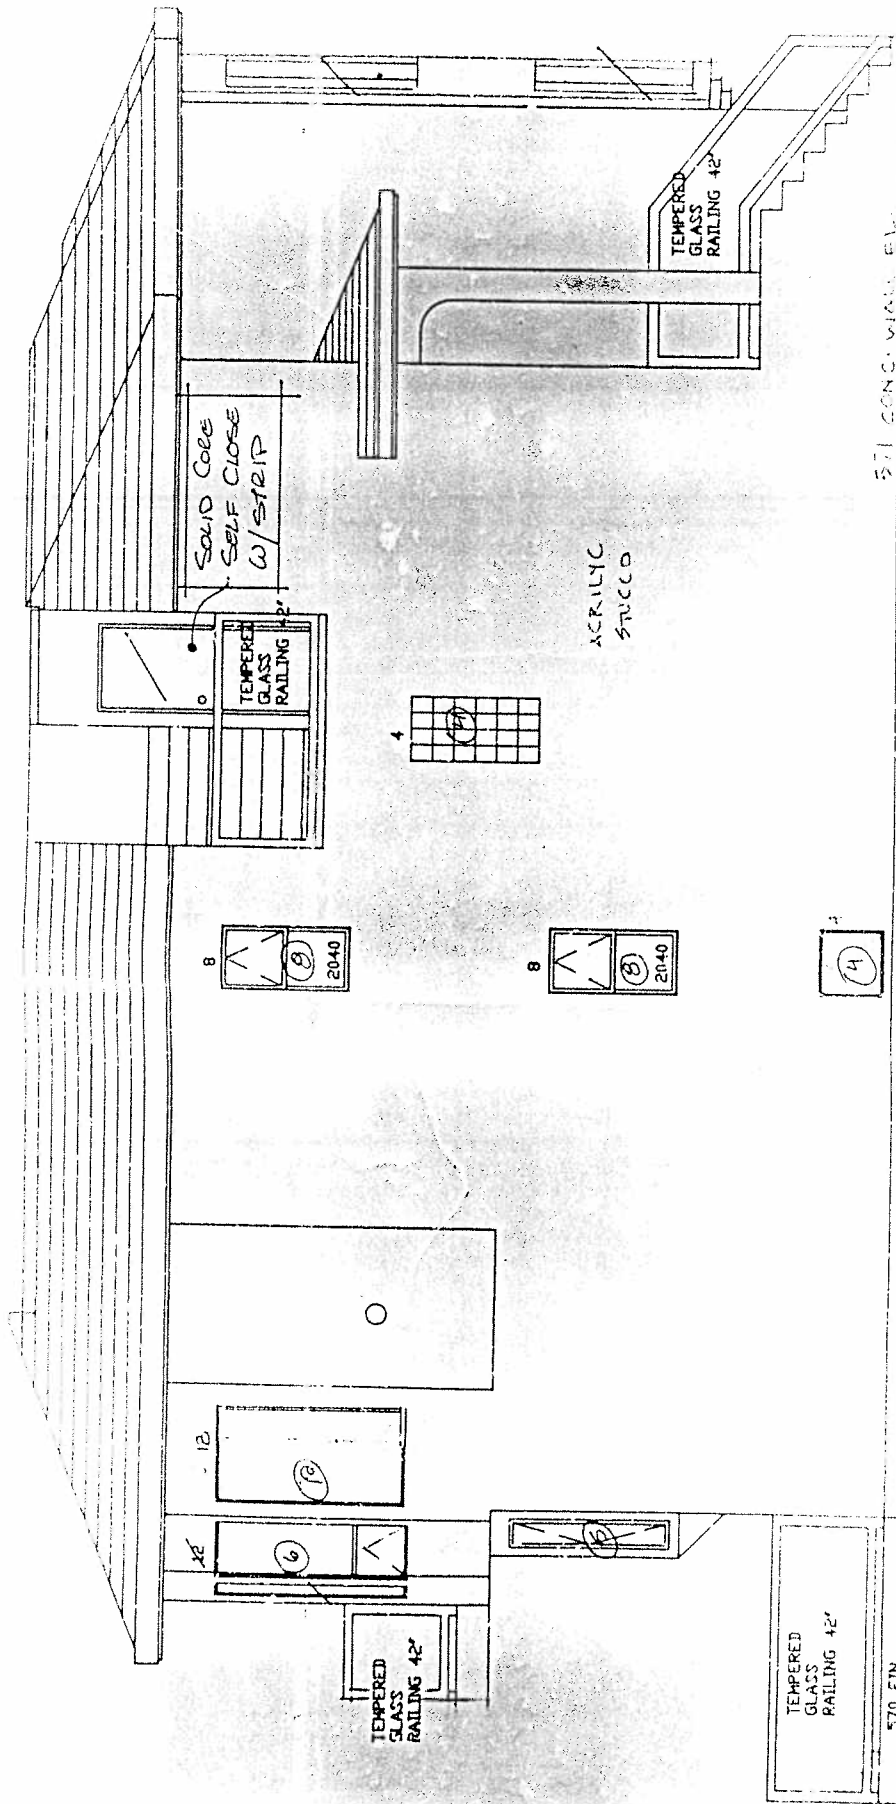

571 CONC. VIAL BL.

570 FIN
5702 EXJR


SOUTH SIDE

L.D. @	4.0'	South	
WALL AREA		=	1015.9
OPEN PERM (7%)		=	71.1
OPEN ACTUAL		=	471.05

Note: Owner is aware that if drainage may not be possible sewer connections in the building, and shall be the

Signature _____

Approved by: [Signature]
Date: [Date]

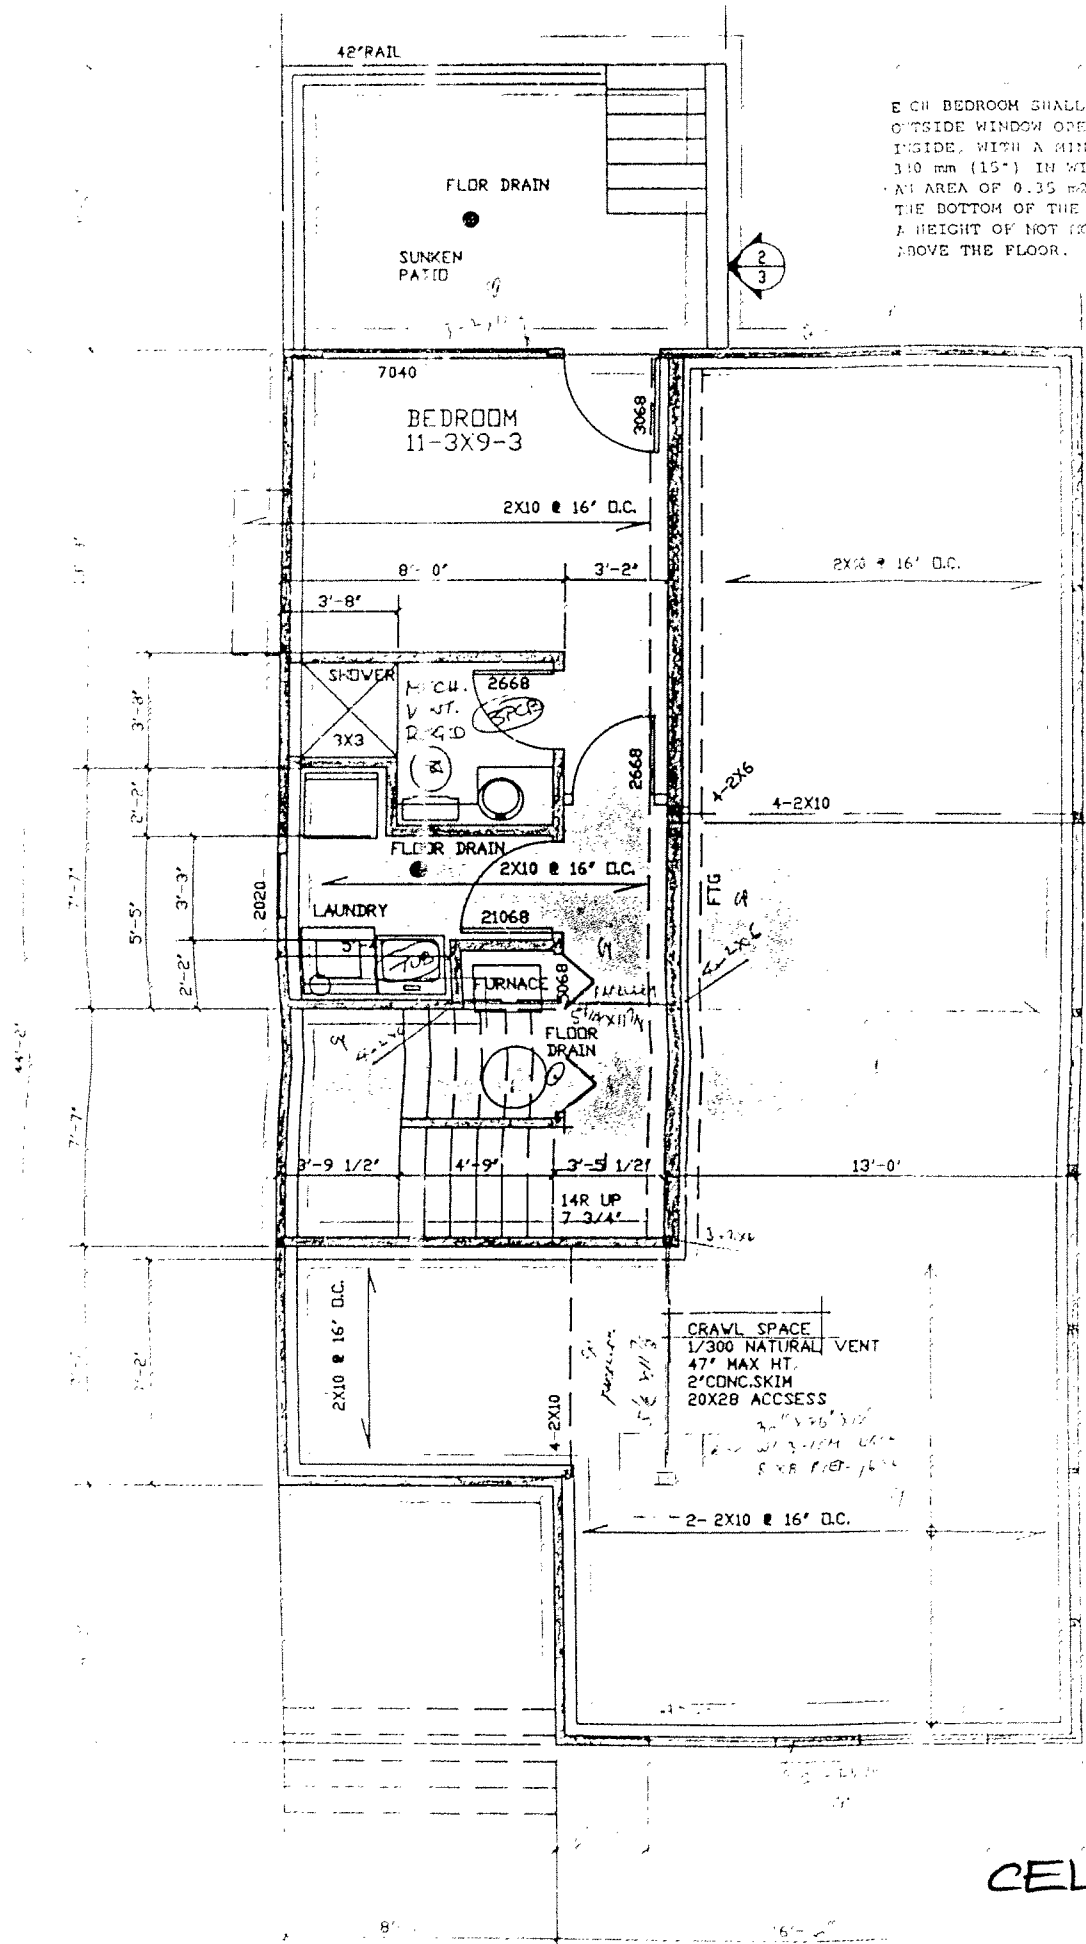

EACH BEDROOM SHALL HAVE AT LEAST ONE OUTSIDE WINDOW OPENABLE FROM THE INSIDE, WITH A MINIMUM DIMENSION OF 380 mm (15") IN WIDTH AND HEIGHT AND AN AREA OF 0.35 M² (3.77 SQ. FT.). THE BOTTOM OF THE OPENING SHALL BE AT A HEIGHT OF NOT MORE THAN 1.0 M (3.28') ABOVE THE FLOOR.

CELLAR PLAN